GENERAL NOTES:

1. CONNECT ALL EXIT AND EM LIGHTS TO CIRCUITS SHOWN AHEAD OF LOCAL SWITCHING.
2. LUMINAIRES DENOTED "NL" SHALL BE CONNECTED AHEAD OF LOCAL SWITCHING.
3. REFER TO ARCHITECTURAL REFLECTED CEILING PLAN FOR EXACT LIGHTING FIXTURE LOCATIONS.
4. REFER TO MECHANICAL PLANS FOR EXACT LOCATIONS OF ALL MECHANICAL EQUIPMENT.
5. ALL CONDUCTORS SHALL BE COPPER AND #12 UNLESS OTHERWISE NOTED.
6. ALL SWITCHES, CONVENIENCE RECEPTACLES, AND PLATES SHALL BE WHITE NONMETALLIC UNLESS NOTED. CONFIRM COLOR WITH ARCHITECT PRIOR TO ORDERING DEVICES.
7. LABEL ALL JUNCTION BOXES WITH CIRCUIT NUMBERING DURING ROUGH-IN OF CONDUIT SYSTEM.
8. COPIES OF ALL INSTALLATION, OPERATIONAL AND MAINTENANCE MATERIALS ARE TO BE SAVED PROVIDED TO THE PROJECT MANAGER FOR ASSEMBLY AND DELIVERY TO THE CONTRACTOR AND OWNER.
9. THE ELECTRICAL CONTRACTOR JOB FORMAN SHALL DOCUMENT ALL UNDERGROUND FEEDERS AS WELL AS ANY DEVIATIONS TO THE CONSTRUCTION DOCUMENTS ON THE RECORD DRAWINGS. SHOW DIMENSIONS ONLY WHEN ACCURACY CAN BE ASSURED.
10. FIRE ALARM DEVICES ARE NOT SHOWN ON DRAWINGS AT THIS TIME. FIRE ALARM SHOP DRAWINGS SHALL BE PROVIDED BY A LICENSED FIRE ALARM CONTRACTOR AND SIGNED AND SEALED BY A PROFESSIONAL ENGINEER. FINAL LOCATIONS OF DEVICES, ONCE APPROVED BY THE AHJ, WILL THEN BE TRANSFERRED TO THE ELECTRICAL CONSTRUCTION DRAWINGS.

DETAIL NOTES: THIS SHEET ONLY

<1> SEE POLE BASE DETAILS ON SHEET S5.1.

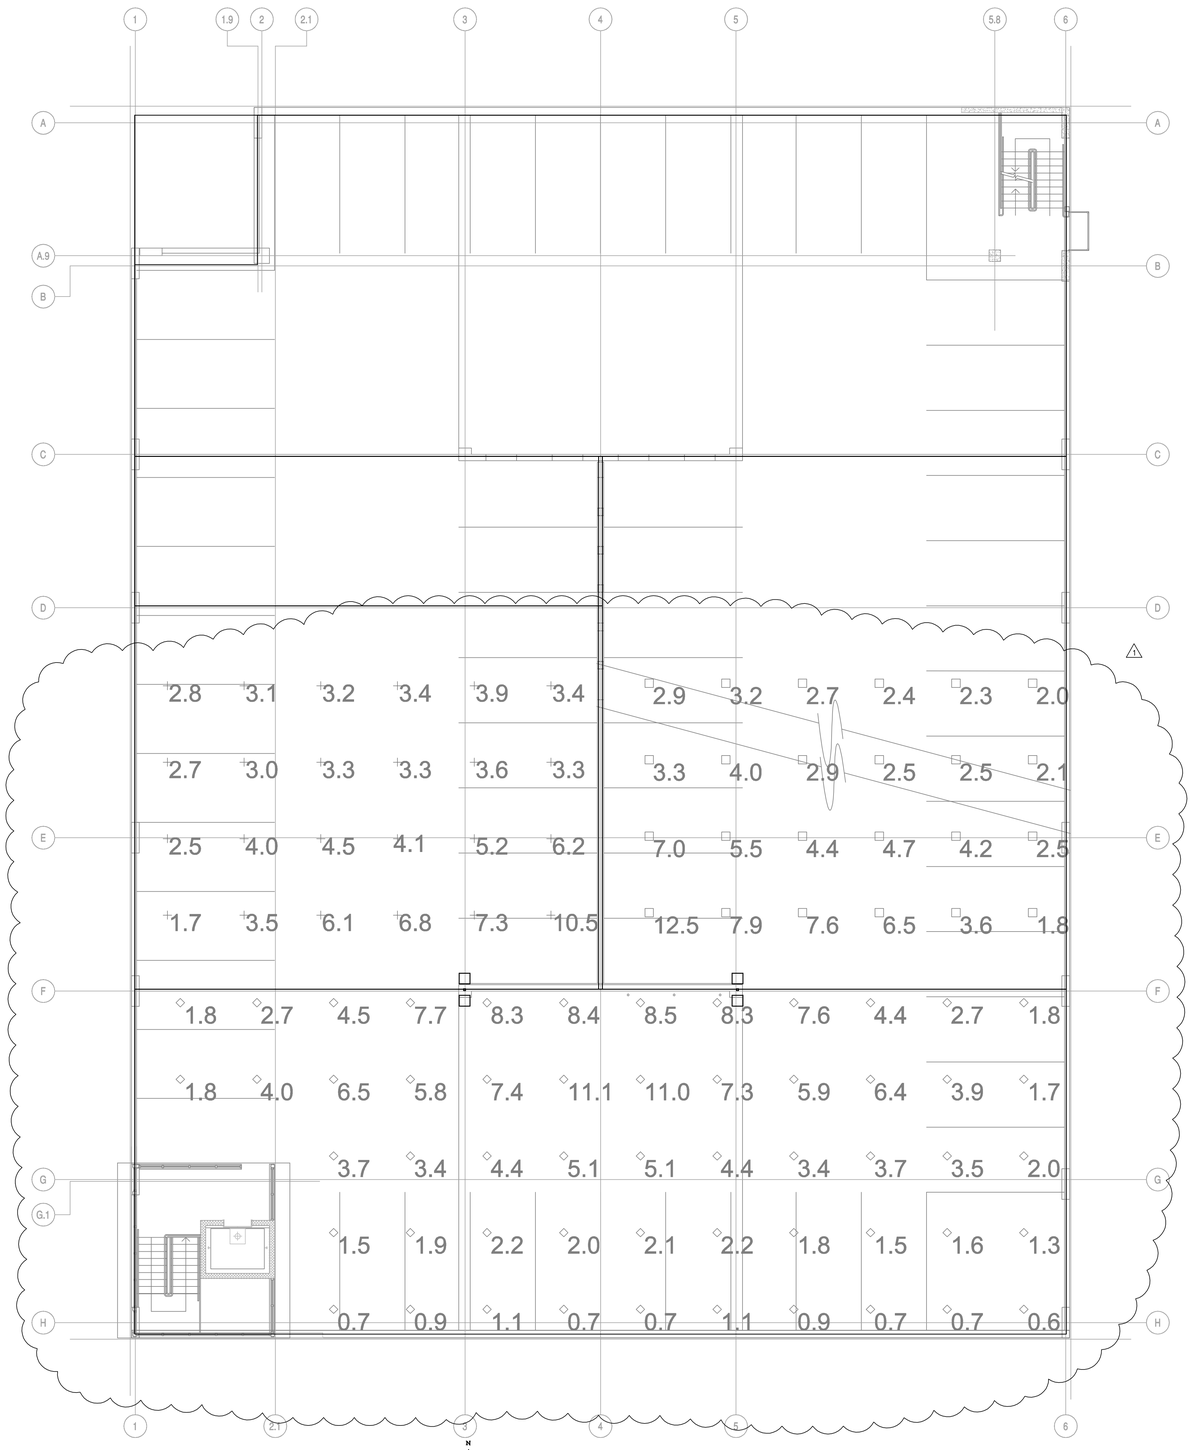

LEVEL 3 – PHOTOMETRIC PLAN
SCALE = 1/8" = 1'-0"

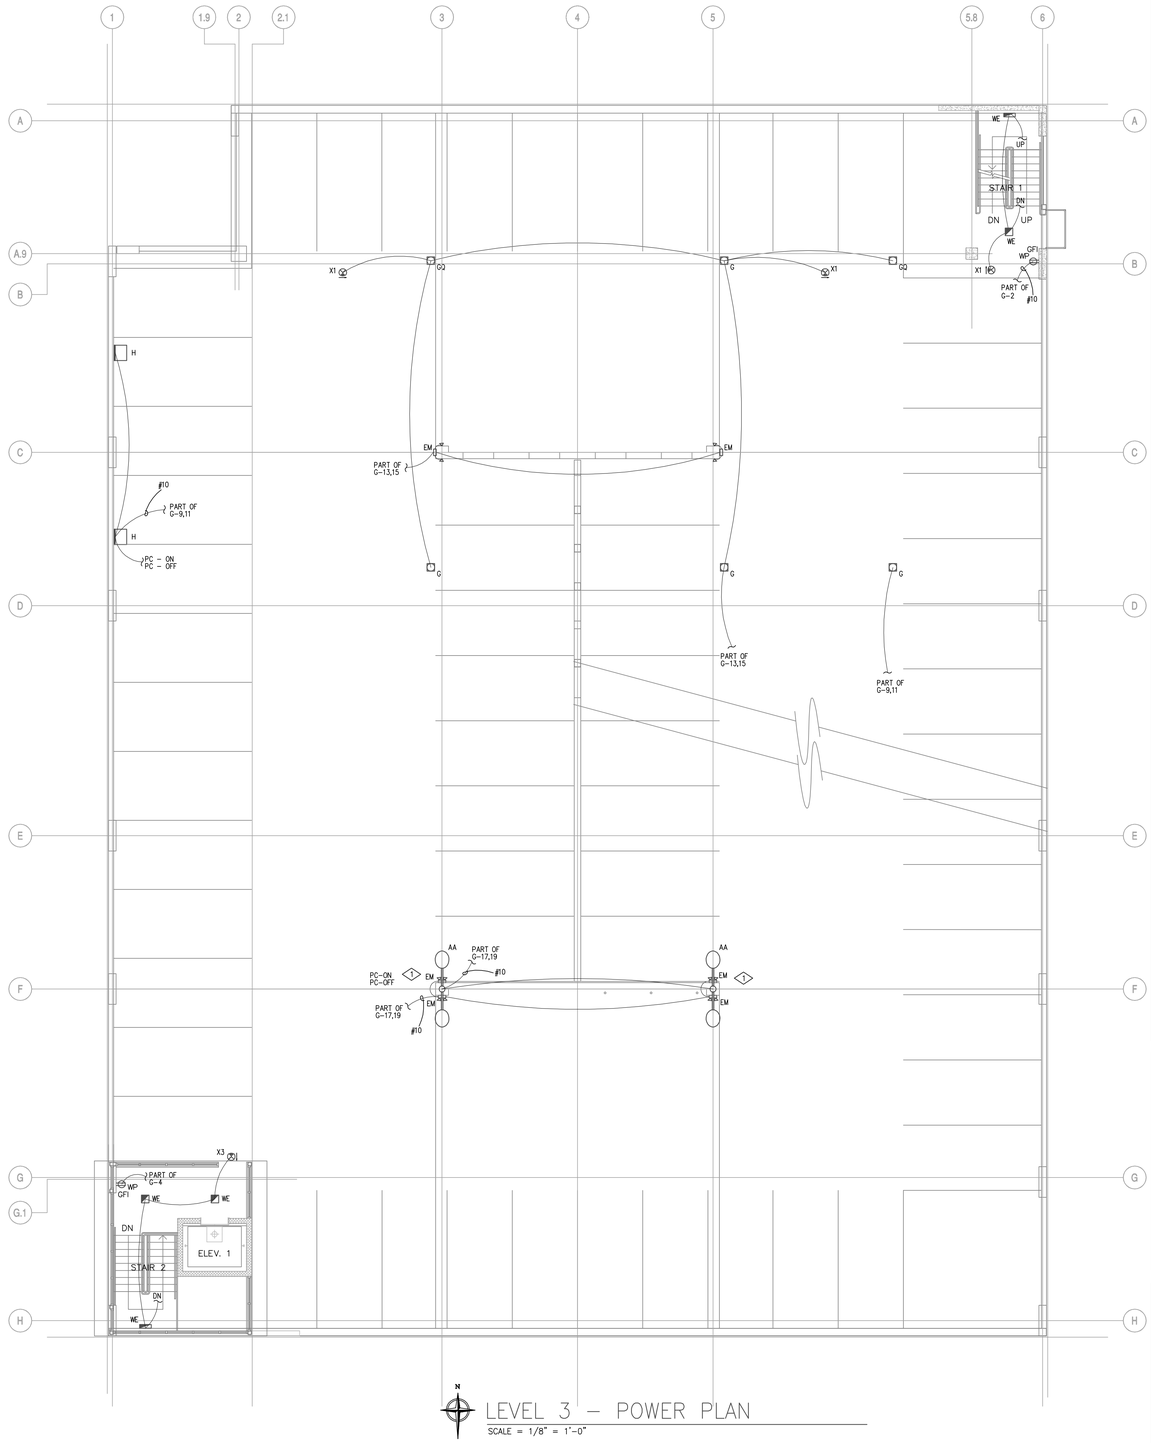

LEVEL 3 – POWER PLAN
SCALE = 1/8" = 1'-0"

OZ ARCHITECTURE
1820 Folsom Street
Boulder, Colorado 80302
phone 303.449.8900

NexCore GROUP

SRB CONSULTING ENGINEERING
MECHANICAL • ELECTRICAL • PLUMBING
548 8th Street Southeast, Building A, Unit A, Loveland, CO 80537
Ph: 970.461.1332
Fax: 970.461.1335
Email: info@srbeng.net

BRET'S ELECTRIC LLC
THORNTON, CO
303-254-8810
www.bretselectric.com

GOLDEN GURA GARAGE

Jackson St.
Golden, Colorado

PROJ. NO. 15038.00
DRAWN: LNS/CW
CHECKED: LNS
CADD FILE: 5060 Garage-3
DATE: 6.16.2006
REVISIONS:
<1> 07/11/06

©OZ ARCHITECTURE

GATEWAY STATOIN
100% CD
SHEET TITLE:
LEVEL 3
POWER PLAN

SCALE:AS NOTED
SHEET NUMBER:
E2.03